Summer Bay
Hull No. 2393

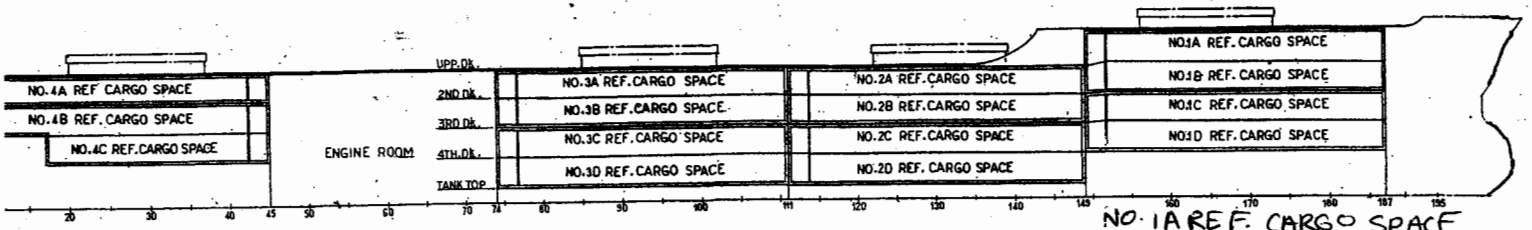

NO.1A REF. CARGO SPACE

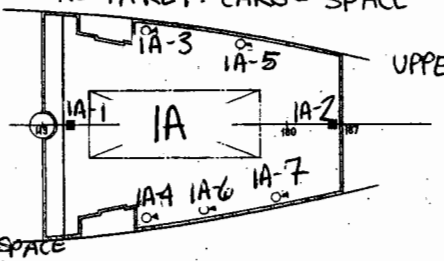

UPPER DECK

NO.4A REF.CARGO SPACE NO.3A REF CARGO SPACE NO.2A REF.CARGO SPACE NO.1B REF CARGO SPACE

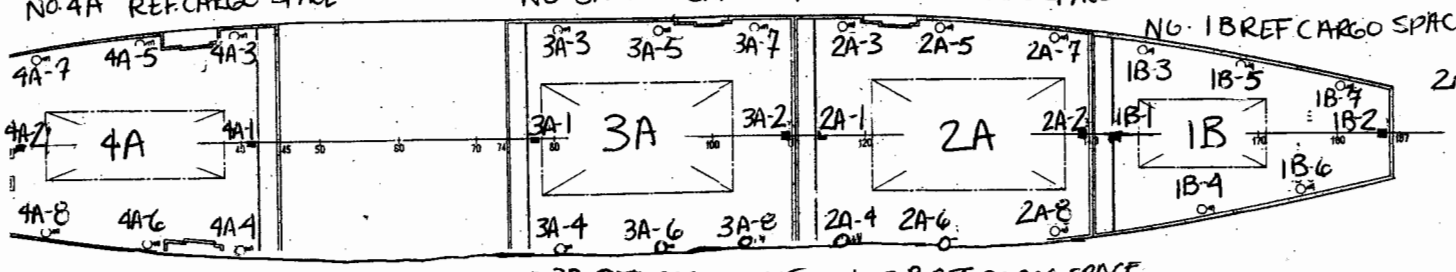

2ND DECK

NO.4B REF CARGO SPACE NO.3B REF. CARGO SPACE NO.2B REF. CARGO SPACE NO.1C REF CARGO SPACE

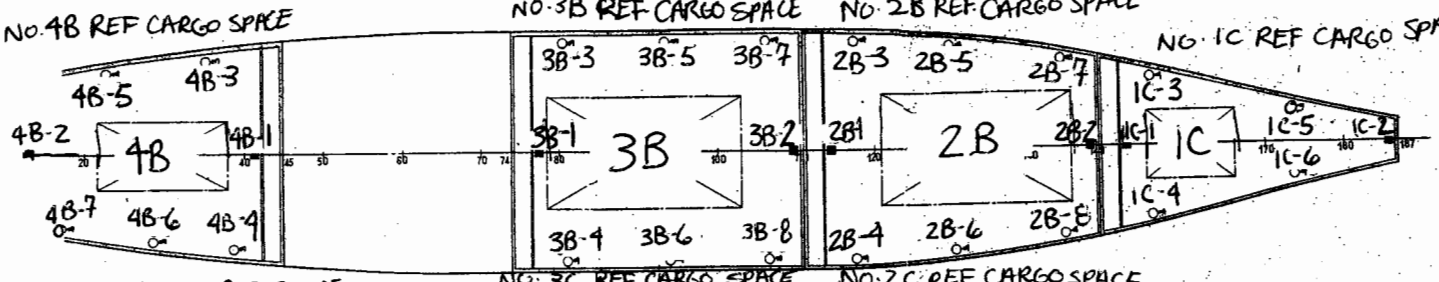

3RD DECK

NO.4C REF.CARGO SPACE NO.3C REF. CARGO SPACE NO.2C REF CARGO SPACE NO.1D REF.CARGO SPACE

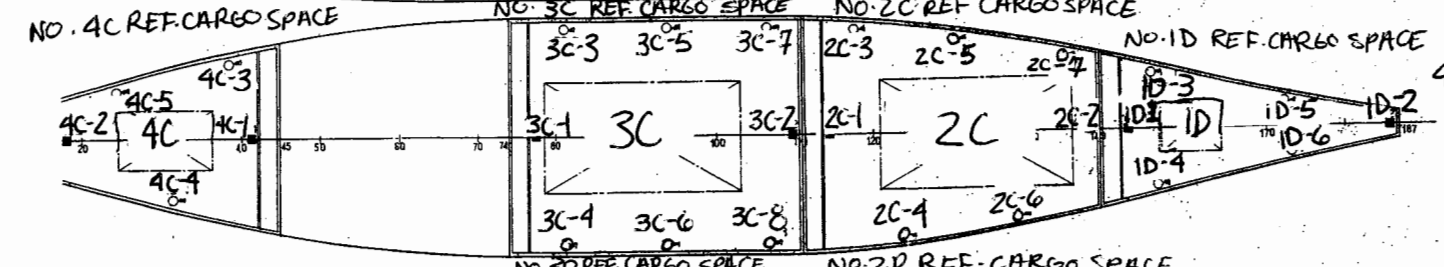

4TH DECK

NO.3D REF. CARGO SPACE NO.2D REF. CARGO SPACE

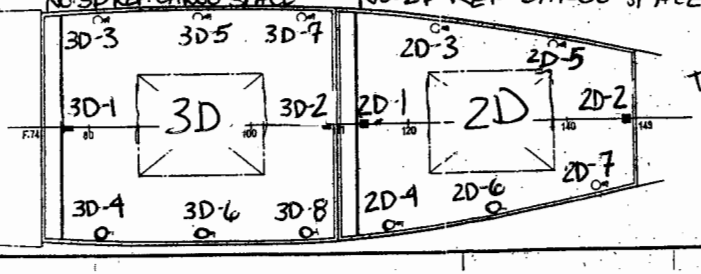

TANK TOP

FOR APPROVAL

■ SHOWS FIXED SENSOR
○ SHOWS FLEXIBLE SENSOR

NIPPON SABROE CO.,LTD. SEP. 3.1984 PLANT DESIGNING SECTION

H. Eguchi

DESIGN DEPARTMENT NIPPON SABROE CO., LTD.		~~MESSRS. SASEBO HEAVY INDUSTRIES CO. LTD. SASEBO SHIPYARD S/NO. 2391~~ MESSRS. KURUSHIMA DOCK YARD CO., LTD. S/NO. ~~2392~~ 2393	
DEP. CHIEF		also 35' boats	
SECT. CHIEF		ARRANGEMENT OF SENSOR	
CHECKER		(FOR REF. CARGO PLANT)	
DRAWER			
DATE DRAWN	SCALE	CODE No.	DRAWING No. / REVISED
	∽	12 – 8026	34429

C.NO. 4653A・4654A・4655A・4656A・